GENERAL NOTES

DRAWING LIST

SITE PLANS - MINOR BLOW OFF

VAULT CONNECTION PROFILES

PRV GRADING PLAN

C-04

SITE PLAN - U-111 / 10200 SOUTH CONNECTION

١.	EXISTING UTILITIES SHOWN ARE BASED ON BEST AVAILABLE INFORMATION. THE CONTRACTOR SHALL VERIFY THE
	EXACT LOCATION, SIZE, TYPE, AND ELEVATION OF ALL UTILITIES PRIOR TO CROSSING UTILITY. THE CONTRACTOR
	SHALL CONTACT BLUE STAKES AT 1 (800) 662-4111 FOR MARK OUT OF EXISTING UTILITIES.

- 2. FOR THE REPLACEMENT AND RECONSTRUCTION OF SOUTH JORDAN CITY AND CITY OF HERRIMAN FACILITIES DAMAGED DURING CONSTRUCTION, REFER TO SPECIFICATION SECTION 01 31 13, PROJECT COORDINATION
- 3. EXCAVATION LIMITS SHOWN IN THE DETAILS ARE GRAPHICAL REPRESENTATIONS ONLY AND DO NOT REPRESENT ACTUAL EXCAVATION LIMITS OR SAFE TRENCH CONDITIONS NECESSARY TO COMPLETE THE WORK. THE CONTRACTOR IS SOLELY RESPONSIBLE FOR DETERMINING THE TRENCH LIMITS NEEDED FOR THE WORK AND CONFORMANCE WITH THE LOCAL, STATE, AND FEDERAL CODES GOVERNING SHORING, SHEETING, AND BRACING OF EXCAVATIONS AND TRENCHES, AND FOR PROTECTION AND SAFETY OF WORKERS AND OTHER CONSTRUCTION RELATED PERSONNEL. PROVIDE SHORING, SHEETING, AND BRACING AS REQUIRED TO PROTECT EXISTING FACILITIES AND WHERE SPECIFICALLY INDICATED ON THE DRAWINGS.
- UNLESS OTHERWISE NOTED, ALL ELEVATIONS FOR NEW CONSTRUCTED PIPELINES ARE PIPE CENTERLINE ELEVATIONS. ELEVATIONS OF EXISTING UTILITIES ARE CALLED OUT TO INVERT ELEVATION FOR GRAVITY UTILITIES (I.E. STORM DRAIN, SEWER, ETC.) AND TOP OF PIPE FOR EXISTING PIPELINES OR CONDUITS FOR ALL OTHER BURIED UTILITIES.
- ALL STATIONING AND DISTANCES SHOWN ON THE DRAWINGS ARE BASED ON HORIZONTAL MEASUREMENTS.
- CONTRACTOR SHALL EXCAVATE AHEAD AND UNCOVER ALL UNDERGROUND LITHLITY CROSSINGS A MINIMUM OF 2 WEEKS IN ADVANCE OF OPERATIONS IN ORDER TO VERIFY CLEARANCE OF EXISTING UTILITIES FROM THE PROPOSED PIPELINE. REPORT ANY CONFLICTS TO THE ENGINEER IMMEDIATELY.
- CONTRACTOR SHALL LIMIT CONSTRUCTION ACTIVITIES TO STAY WITHIN THE WORK LIMITS SHOWN AND COMPLY WITH TRAFFIC CONTROL REQUIREMENTS. THIS SHALL INCLUDE, BUT NOT BE LIMITED TO, VEHICLES AND EQUIPMENT, LIMITS OF EXCAVATION, EXCAVATED MATERIAL, AND BACKFILL MATERIAL STORAGE. WHERE EASEMENTS ARE NOT SHOWN, LIMIT CONSTRUCTION ACTIVITIES TO STAY WITHIN ROAD RIGHTS-OF-WAY AND PERMANENT EASEMENTS UNLESS OTHERWISE SHOWN
- CONTRACTOR SHALL ENSURE THAT OPERATION OF EXISTING IRRIGATION, SEWER, DRAINAGE, DOMESTIC WATER, AND OTHER UTILITY SYSTEMS ARE CONTINUOUS DURING CONSTRUCTION. THE CONTRACTOR SHALL NOT ASSUME THERE ARE FEWER SERVICE LATERALS (FOR WATER, AND ALSO ALL OTHER UTILITIES, WHETHER SHOWN ON THE PLANS OR NOT), THAN THERE ARE HOMES OR OTHER STRUCTURES, WHERE PROJECT TRENCHES ARE LOCATED BETWEEN A HOME OR STRUCTURE AND THE UTILITY MAIN. WHERE IT IS NECESSARY TO REMOVE AND REPLACE OR TO RELOCATE SUCH UTILITIES OR SERVICE LATERALS IN ORDER TO PROSECUTE THE WORK. THEY SHALL BE REMOVED, MAINTAINED, AND PERMANENTLY REPLACED BY THE CONTRACTOR, AT HIS EXPENSE, AND TO THE SATISFACTION AND STANDARDS OF THE UTILITY OWNER.
- SURFACE RESTORATION SHALL BE AS SPECIFIED OR SHOWN ON THE DRAWINGS. RESTORE SURFACES TO EXISTING CONDITIONS MAINTAINING EXISTING DRAINAGE PATHS UNLESS NOTED OTHERWISE
- 10. RIPARIAN VEGETATION DISTURBED BY CONSTRUCTION ACTIVITIES SHALL BE REPLACED AND MAINTAINED UNTIL ESTABLISHED. THE CONTRACTOR SHALL APPLY VEGETATIVE EROSION CONTROL PER SPECIFICATIONS AND DRAWINGS. TO AREAS DISTURBED BY CONSTRUCTION ACTIVITIES AND NOT LANDSCAPED
- PIPE CONSTRUCTION IN SEVERAL PROJECT AREAS IS NEAR EXISTING WATER MAINS WHICH, WITHOUT APPROPRIATE CONTRACTOR-PROVIDED SHEETING, SHORING, AND PROTECTION, COULD COLLAPSE INTO THE EXCAVATIONS REQUIRED FOR THE PROJECT WORK. THE CONTRACTOR IS REQUIRED TO PROVIDE ALL NECESSARY DESIGNS (SIGNED AND STAMPED BY A PROFESSIONAL ENGINEER IN THE STATE OF UTAH), FOR SHEETING, SHORING AND OTHER PROTECTION TO PREVENT EXISTING WATER SYSTEMS FROM SHIFTING, LEAKING, COLLAPSING, OR OTHERWISE FAILING AS A RESULT OF THIS WORK
- 12. IF EXISTING WATER PIPES MUST BE TAKEN OUT OF SERVICE DURING CONSTRUCTION FOR SAFETY REASONS, PROVIDE ABOVE GROUND PIPES (HIGHLINING) TO MAINTAIN CONTINUOUS WATER SERVICES EQUIVALENT TO EXISTING SYSTEM SERVICE. COORDINATE WITH THE UTILITY OWNER OF THE UTILITY TO BE TAKEN OUT OF SERVICE TO ESTABLISH AN ACCEPTABLE TIME AND TO DEFINE WHAT IS AN ACCEPTABLE EQUIVALENT TO EXISTING SYSTEM SERVICE
- 13. ANY DAMAGE WHICH OCCURS TO EXISTING WATER SYSTEMS AS A RESULT OF THE CONTRACTOR'S WORK SHALL BE PROMPTLY REPAIRED OR REPLACED AT THE CONTRACTOR'S EXPENSE PER PROJECT REQUIREMENTS, AND TO THE SATISFACTION OF THE OWNER OF THE DAMAGED WATER MAINS.
- 14. RELOCATIONS AND/OR REPLACEMENTS OF EXISTING UTILITIES SHALL BE COORDINATED BY THE CONTRACTOR WITH THE UTILITY OWNER. CONTRACTOR SHALL CONTACT, SCHEDULE, AND ESTABLISH UTILITY SHUT DOWN TIMES AND DETERMINE THE RELOCATION AND/OR REPLACEMENT REQUIREMENTS OF EXISTING LITH ITIES PRIOR TO THE START OF ANY WORK. THE CONTRACTOR SHALL RELOCATE OR REPLACE EACH UTILITY TO THE SATISFACTION OF THE UTILITY OWNER AND AT NO COST TO THE UTILITY OR OWNER
- 15 IMPROVEMENTS DESIGNATED FOR DEMOLITION SHALL BE DEMOLISHED AND DISPOSED OFF SITE BY THE CONTRACTOR. ALL PAVEMENT SHALL BE SAWCUT PRIOR TO REMOVAL. ROUGH EDGES SHALL AGAIN BE SAWCUT PRIOR TO INSTALLATION OF PAVEMENT REPAIR. THE RIGHT-OF-WAY SHALL BE RESTORED TO ORIGINAL GRADE AND EXISTING DRAINAGE PATTERNS SHALL BE MAINTAINED UNLESS NOTED OTHERWISE
- 16. CONTRACTOR SHALL REPLACE TO ORIGINAL OR BETTER CONDITION ALL FENCES REMOVED OR DAMAGED BY ANY PROJECT RELATED WORK WITH NEW FENCING AT THE ORIGINAL HORIZONTAL LOCATION UNLESS OTHERWISE SHOWN ON THE DRAWINGS. NEW FENCING SHALL BE EQUAL TO OR BETTER THAN THE ORIGINAL FENCING
- 17. CONTRACTOR SHALL MAINTAIN ACCESS TO ALL POSTAL FACILITIES, INCLUDING MAIL BOXES, AT ALL TIMES DEEMED NECESSARY BY THE U.S. POSTAL DEPARTMENT.
- 18. CONTRACTOR SHALL COORDINATE CONSTRUCTION ACTIVITIES WITH LOCAL EMERGENCY SERVICES TO ENSURE ACCESS TO ALL RESIDENTIAL, COMMERCIAL, AND OCCUPIED FACILITIES AT ALL TIMES.
- 19. ACCORDING TO UTAH CODE R309-550-7, WATER LINES ARE REQUIRED TO HAVE A MINIMUM 10 FT HORIZONTAL, AND 18" VERTICAL SEPARATION FROM SEWER LINES.

SHEET NO.	DWG NO.	SHEET TITLE/DESCRIPTION	SHEET NO.	DWG NO.	SHEET TITLE/DESCRIPTION
	G-01 G-02 G-03	GENERAL COVER SHEET, LOCATION, AND VICINITY MAPS GENERAL NOTES AND DRAWING LIST ABBREVIATIONS		PA-01 PA-02 PA-03	PIPELINE APPURTENANCES AIR VALVE VAULT PLANS AND SECTION MINOR BLOW OFF AND DETAILS MANWAY ACCESS VAULT PLAN AND SECTIONS HEDBLANA CITY THOUSE TO AND SECTIONS
	G-04 G-05 G-06	DRAWING INDEX MAP HYDRAULIC PROFILE SURVEY CONTROL PLAN		PA-04 PA-05	HERRIMAN CITY TURNOUT PLANS AND SECTION SOUTH JORDAN CITY TURNOUT PLAN AND SECTIONS
	G-07 G-08 G-09 G-10	SURVEY CONTROL COORDINATES HORIZONTAL PIPELINE CONTROL AND POTHOLE TABLE STANDARD SYMBOLS AND CIVIL LEGEND GENERAL STRUCTURAL NOTES		SM-01 SM-02	STRUCTURAL / MECHANICAL U-111/10200 SOUTH CONNECTION VAULT PIPING AND ROOF PLANS U-111/10200 SOUTH CONNECTION VAULT SECTIONS
	G-11 G-12 G-13	MECHANICAL NOTES AND AND PIPING LEGEND INSTRUMENTATION AND CONTROLS LEGEND SHEET -1 INSTRUMENTATION AND CONTROLS LEGEND SHEET - 2	\bigwedge	SM-03	PRV VAULT PLANS AND SECTION ELECTRICAL
	G-14	ELECTRICAL LEGEND AND ABBREVIATIONS PLAN AND PROFILE	<u> </u>	E-01 E-02 E-03	SITE PLAN - U-111 / 10200 SOUTH CONNECTION SITE PLAN - PRV VAULT ONE-LINE DIAGRAMS
	PP-01 PP-02 PP-03	PLAN AND PROFILE STA 1+98± TO STA 10+00 PLAN AND PROFILE STA 10+00 TO STA 20+00 PLAN AND PROFILE STA 20+00 TO STA 30+00		E-04 E-05	ELECTRICAL PLAN - U-111 / 10200 SOUTH CONNECTION VAULT ELECTRICAL PLAN - PRV VAULT
	PP-04 PP-05 PP-06 PP-07	PLAN AND PROFILE STA 30+00 TO STA 40+00 PLAN AND PROFILE STA 50+00 TO STA 50+00 PLAN AND PROFILE STA 50+00 TO STA 60+00 PLAN AND PROFILE STA 60+00 TO STA 70+00		SD-01 SD-02	STANDARD DETAILS STANDARD DETAILS STANDARD DETAILS
	PP-08 PP-09 PP-10	PLAN AND PROFILE STA 70+00 TO STA 80+00 PLAN AND PROFILE STA 80+00 TO STA 90+00 PLAN AND PROFILE STA 90+00 TO STA 107+50		SD-03 SD-04 SD-05	STANDARD DETAILS STANDARD DETAILS STANDARD DETAILS
	PP-11 PP-12 PP-13	PLAN AND PROFILE STA 107+50 TO STA 118+00 PLAN AND PROFILE STA 118+00 TO STA 128+00 PLAN AND PROFILE STA 128+00 TO STA 138+00		SD-06 SD-07 SD-08 SD-09	STANDARD DETAILS STANDARD DETAILS STANDARD DETAILS STANDARD DETAILS
	PP-14 PP-15 PP-16 PP-17	PLAN AND PROFILE STA 138+00 TO STA 148+00 PLAN AND PROFILE STA 148+00 TO STA 158+00 PLAN AND PROFILE STA 158+00 TO STA 168+00 PLAN AND PROFILE STA 168+00 TO STA 178+00		SD-10 SD-11 SD-12	STANDARD DETAILS STANDARD DETAILS STANDARD DETAILS STANDARD DETAILS
	PP-18 PP-19 PP-20	PLAN AND PROFILE STA 178+00 TO STA 188+00 PLAN AND PROFILE STA 188+00 TO STA 198+00 PLAN AND PROFILE STA 198+00 TO STA 208+00		SD-13 SD-14 SD-15	STANDARD DETAILS STANDARD DETAILS STANDARD DETAILS
	PP-21 PP-22	PLAN AND PROFILE STA 208+00 TO STA 218+00 PLAN AND PROFILE STA 218+00 TO STA 226+17±	\bigwedge 1	SD-16 SD-17 SD-18	STANDARD DETAILS STANDARD DETAILS STANDARD DETAILS
	XS-01 XS-02	CROSS SECTIONS CROSS SECTIONS CROSS SECTIONS		SD-19	STANDARD DETAILS
	XS-02 XS-03 XS-04	CROSS SECTIONS CROSS SECTIONS			
	C-01	CIVIL OVERALL SITE PLAN - FUTURE TANKS AND SUPPORTING INFRASTRUCTU			
	C-02	ENLARGED SITE PLAN - FUTURE TANKS AND SUPPORTING INFRASTRUCT	URE		

GENERAL UTILITY RELOCATION NOTES

- 1. EXISTING STORM DRAINS AND SANITARY SEWERS MUST REMAIN IN SERVICE AT ALL TIMES. PROVIDE BYPASS PUMPING AS NEEDED TO FACILITATE CONSTRUCTION
- 2. THOROUGHLY CLEAN EXISTING PIPE TO BE INSERTED OR EMBEDDED IN MANHOLE BASE. OUTSIDE OF PIPE SHALL BE CONDITIONED SO A TIGHT, LEAK FREE SEAL BETWEEN THE PIPE AND THE MANHOLE BASE RESULTS.
- 3. IF MANHOLE BASE IS POURED IN PLACE, THOROUGHLY CLEAN AND APPLY ANTI BONDING AGENT TO EXISTING PIPE TO BE
- 4. GRIND CORNERS OF EXISTING SD AS NEEDED TO ALLOW SMOOTH FLOW INTO NEW SD CHANNEL.
- 5. LOCATION AND VERTICAL ELEVATION OF EXISTING STORM DRAINS AND SANITARY SEWERS ARE ESTIMATES FROM UPSTREAM AND DOWNSTREAM MH'S. ACTUAL LOCATION AND ELEVATION MAY VARY. CONTRACTOR TO VERIFY LOCATION AND ELEVATION PRIOR TO ORDERING MATERIALS. PROVIDE AND SUBMIT GRADES OF NEW PIPES AND ELEVATION OF NEW MANHOLES.
- 6. EXPOSE EXISTING PIPE PRIOR TO CONSTRUCTION TO VERIFY EXISTING PIPE MATERIALS, OD'S, ELEVATION, LOCATION, AND PROXIMITY OF JOINTS AND/OR COUPLINGS TO CONNECTION LOCATIONS. WORK WITH PROJECT REPRESENTATIVE IN FIELD TO ADJUST PIPE LAYOUT IF NECESSARY.
- 7. ALL DAMAGED WATER SERVICES SHALL BE REMOVED AND REPLACED BETWEEN THE WATER MAIN AND THE METER PER CITY STANDARD DETAILS




VALLEY WATE


GENERAL NOTES AND DRAWINGS LIST


ch2m.


VERIFY SCALE BAR IS ONE INCH OF


JANUARY 201 WG G-02 SHEET

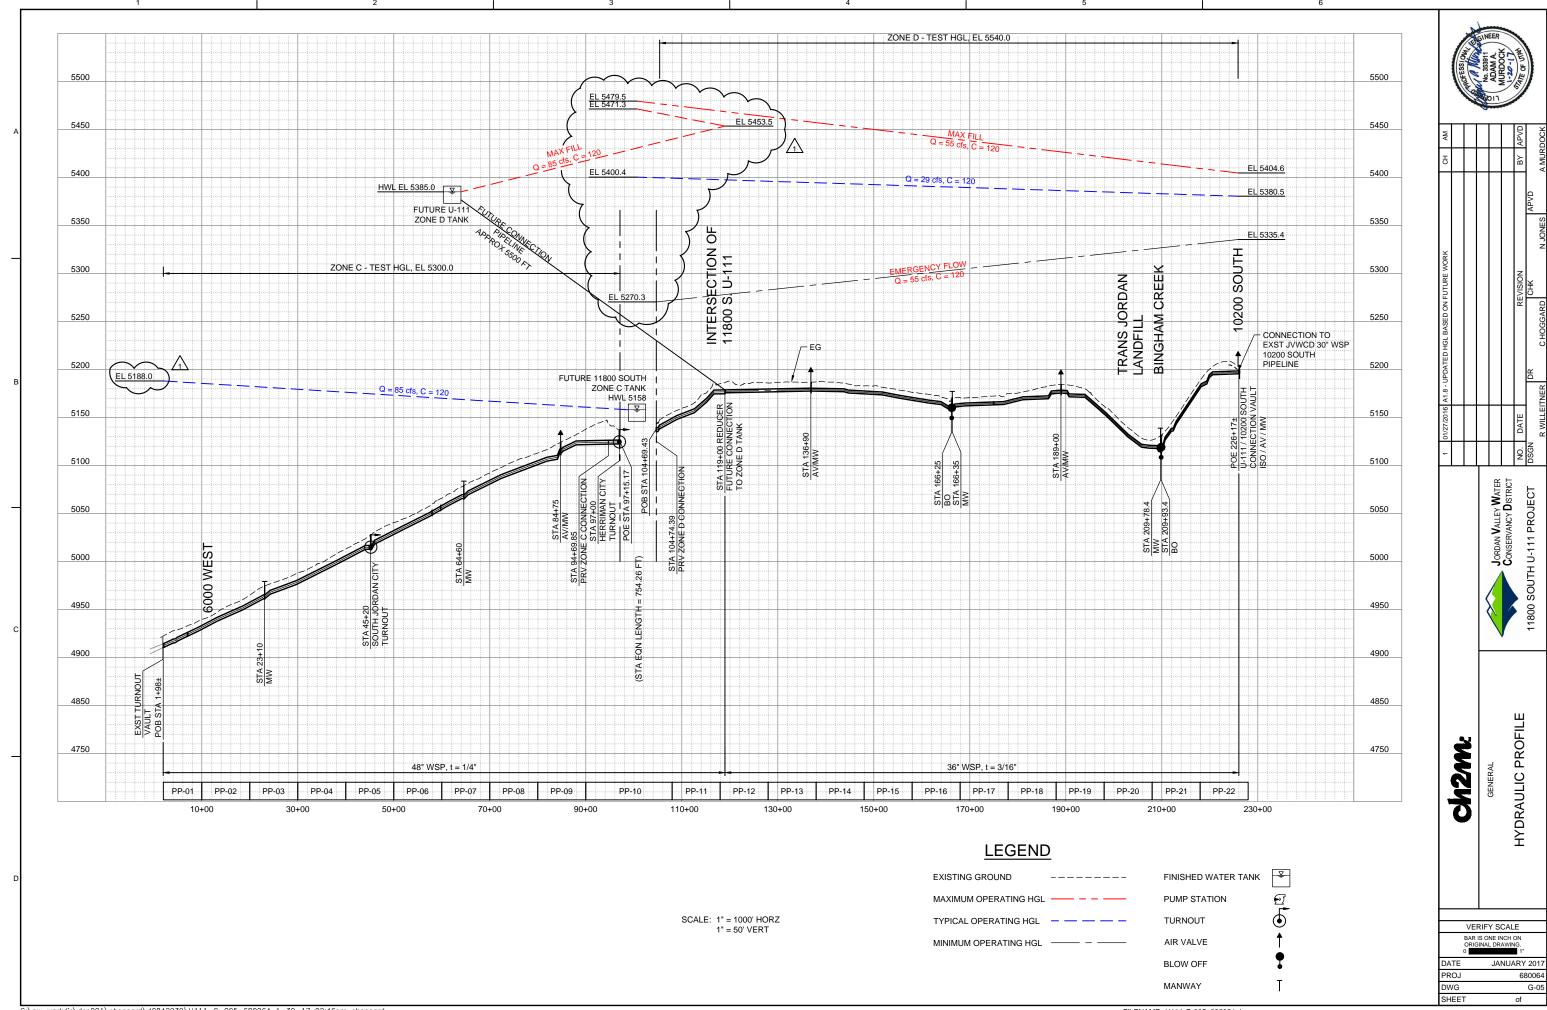

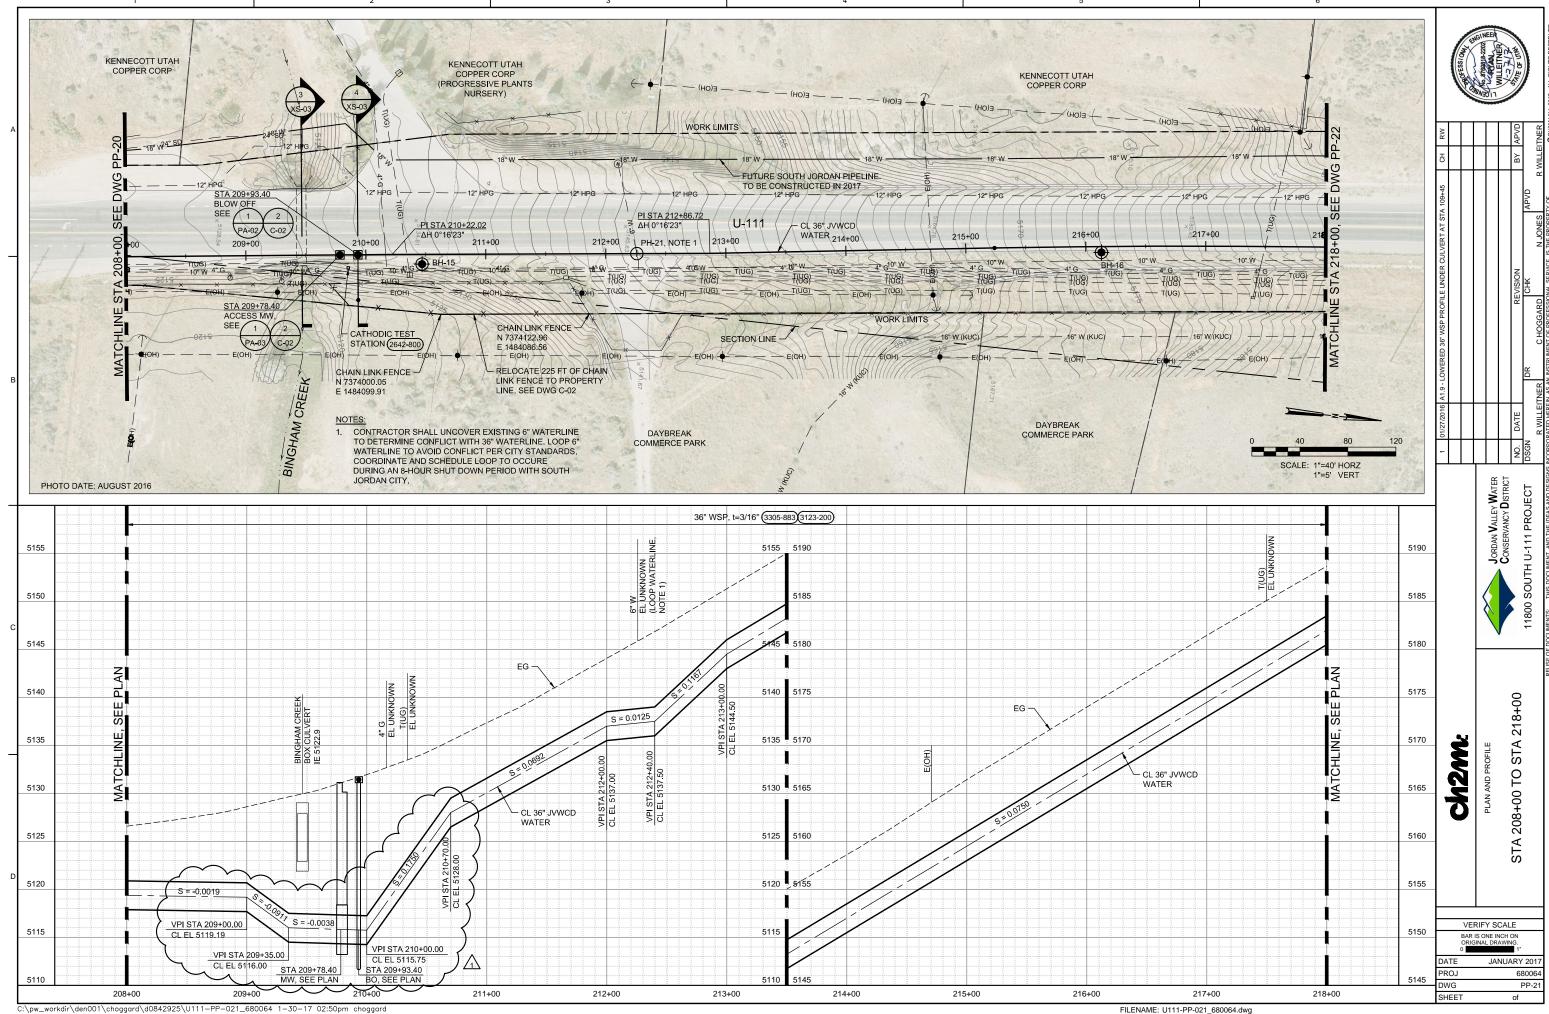

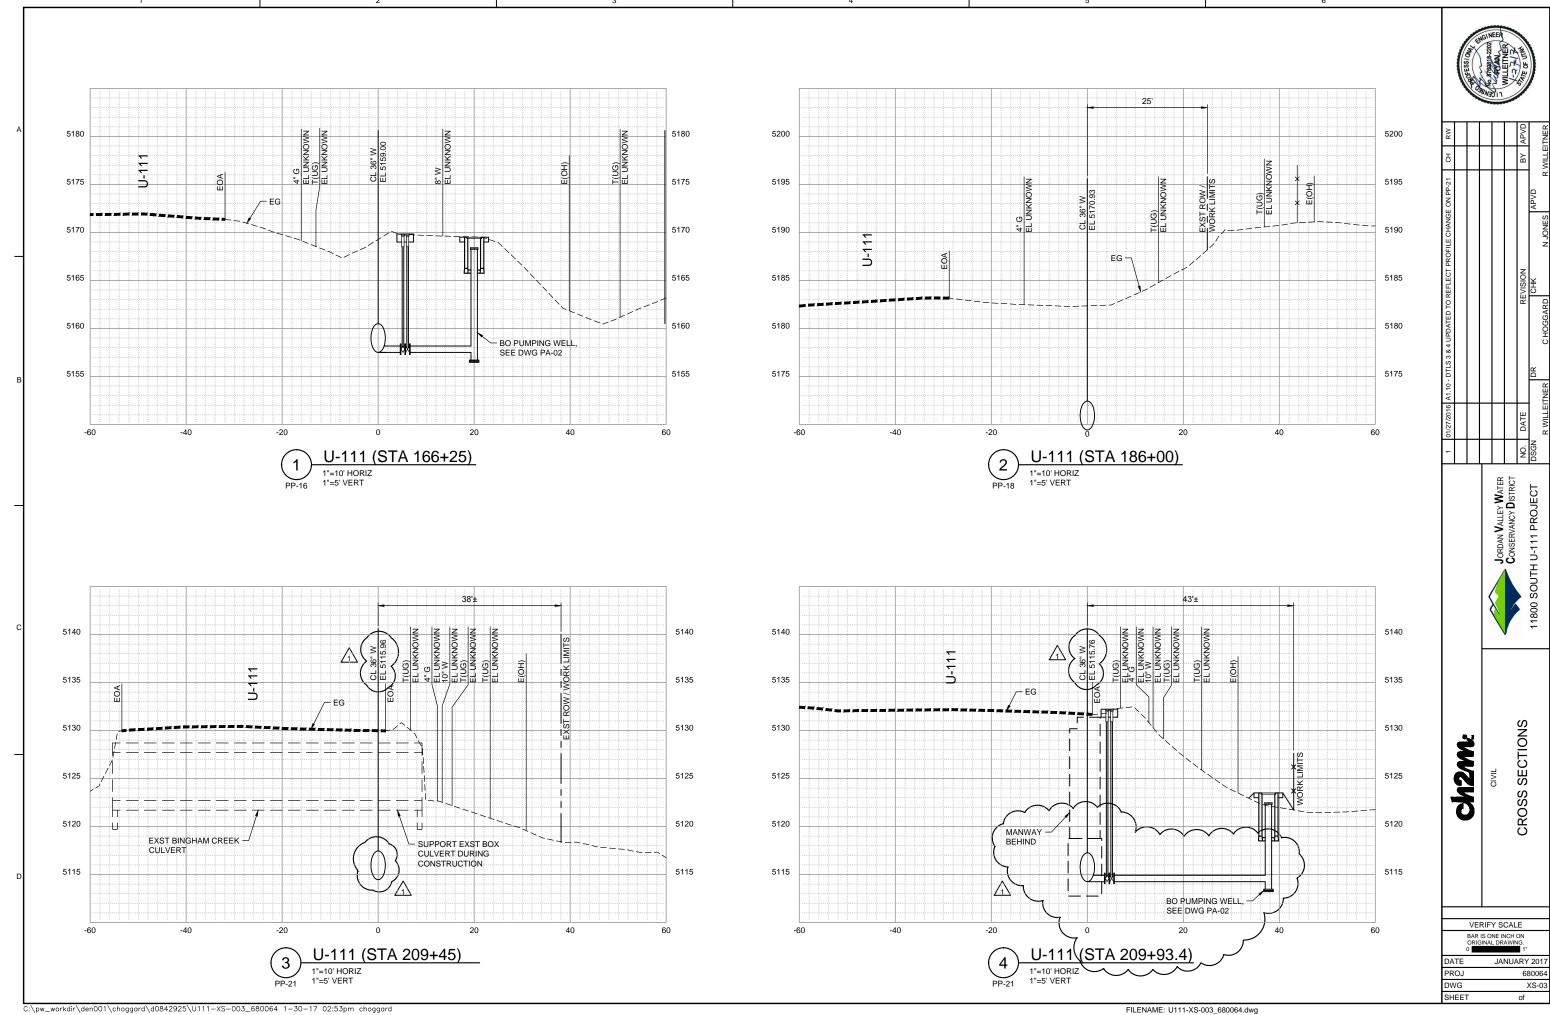

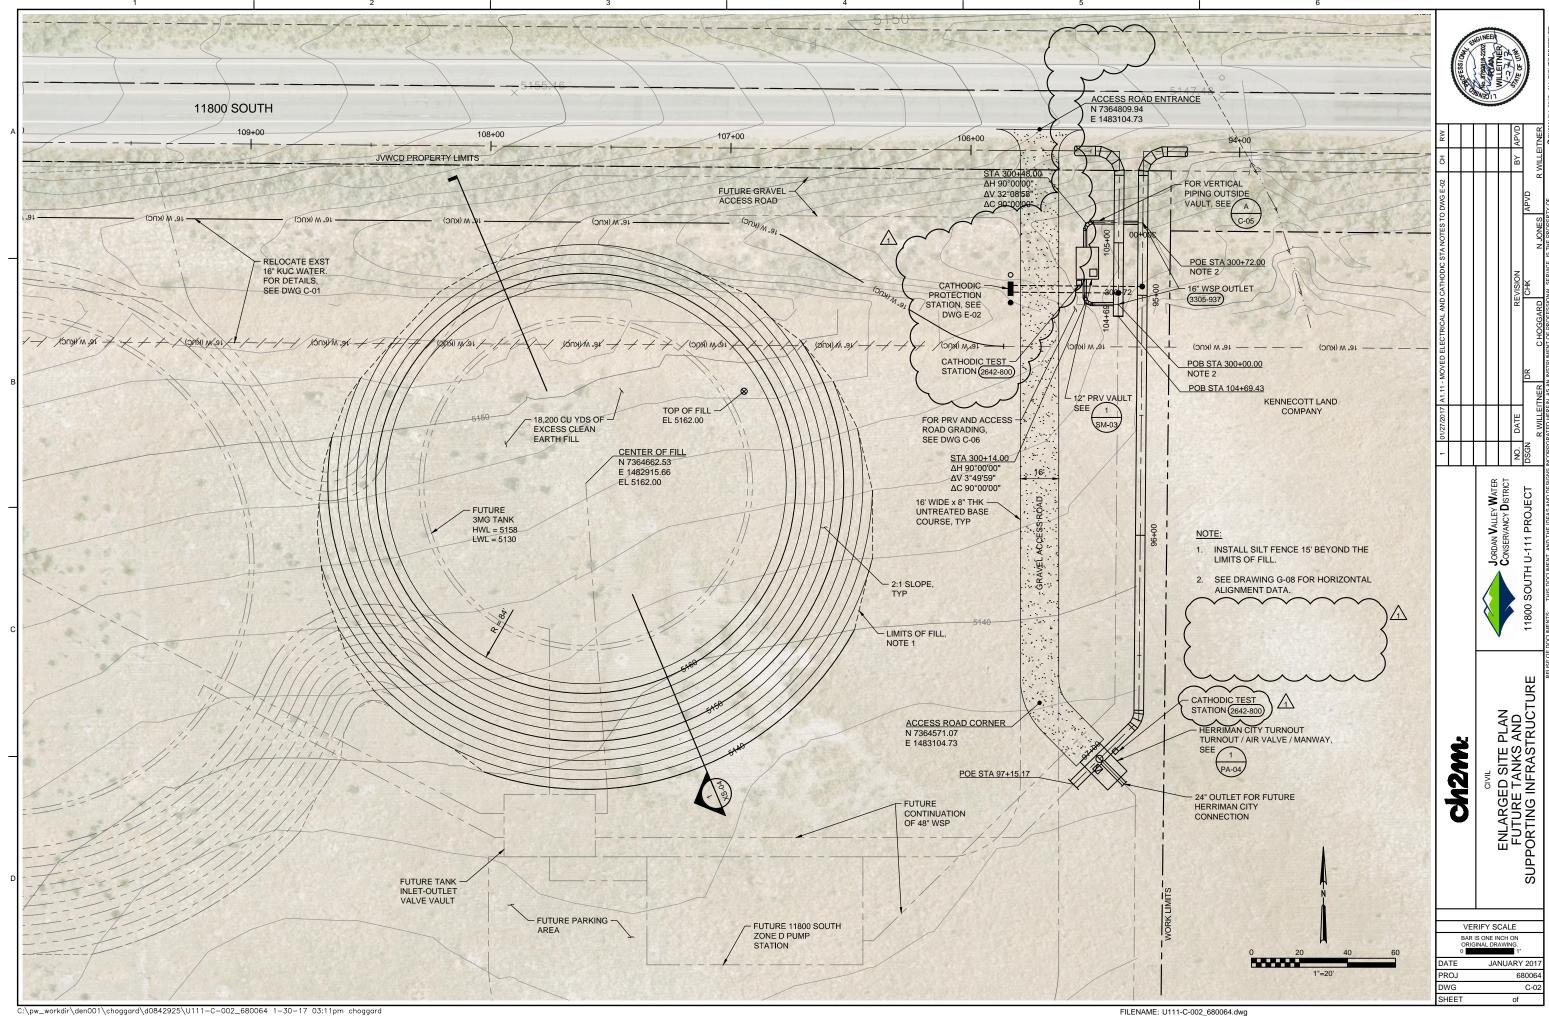

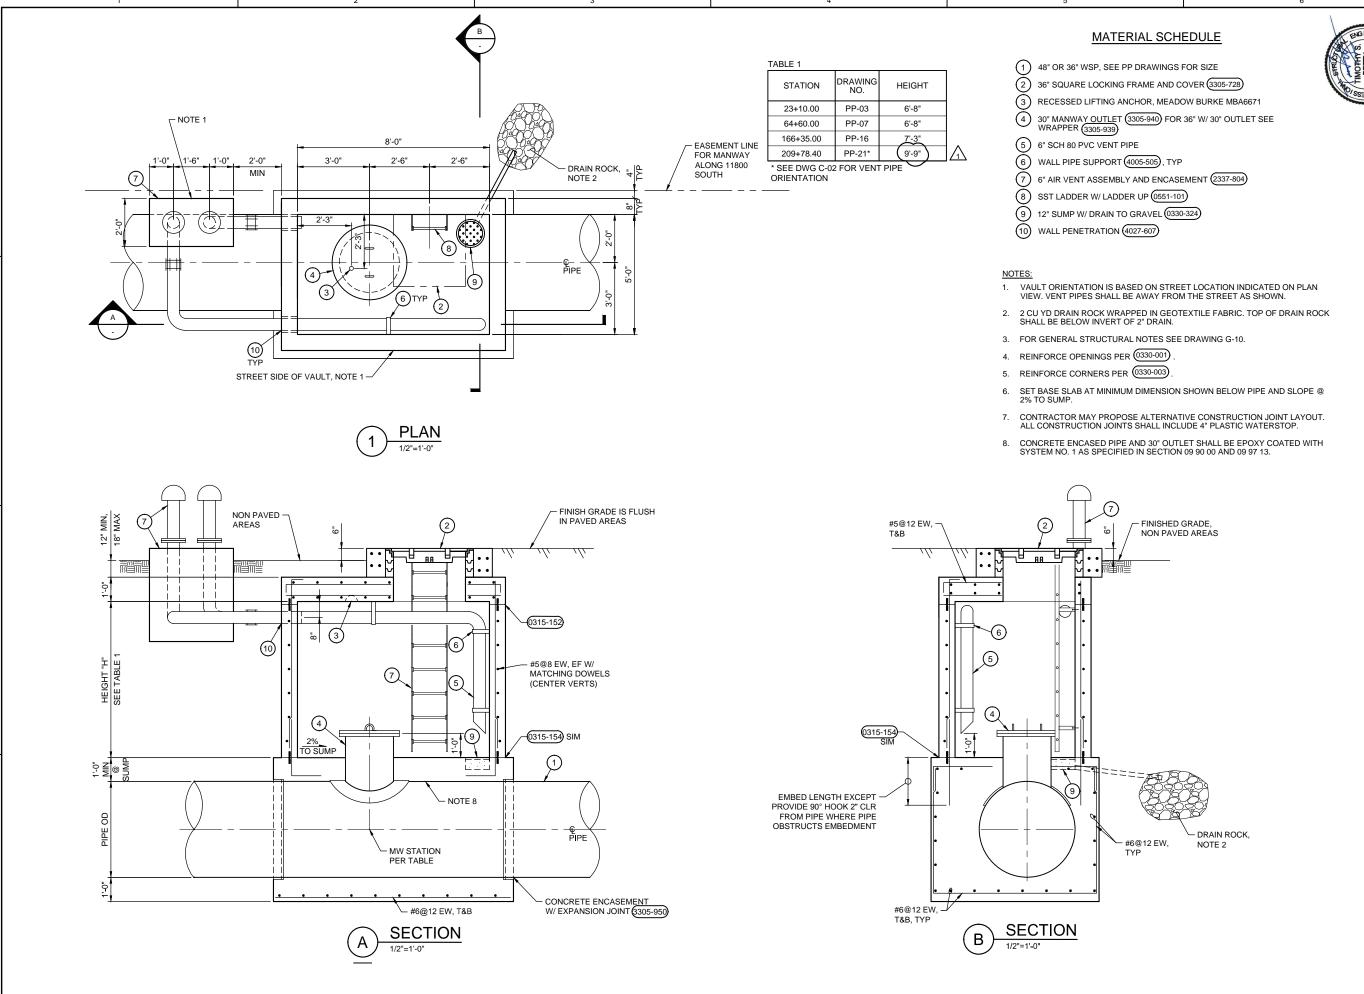



-	01/27/2016	A1.12	01/27/2016 A1.12 - INCREASED HEIGHT IN TABLE AT STA 209+78.4	BLE AT STA 209+78.4		ᆼ	RW
O	DATE		RE	REVISION		ВУ	BY APVD
DSGN			DR	CHK	APVD		
	R WILLEITNER	TNER	CHOGGARD	N JONES	N JONES R WILLEITNER/T PETTY	ER/T F	ETTY
SINCORPO	DRATED HERE	IN AS A	INCORPORATED HEREIN, AS AN INSTRUMENT OF PROFESSIONAL SERVICE, IS THE PROPERTY OF	NAL SERVICE. IS THE PROPERT	TY OF		O CITO


JORDAN VALLEY WATER
CONSERVANCY DISTRICT

MANWAY ACCESS VAULT PLAN AND SECTIONS

ch2m.

VERIFY SCALE BAR IS ONE INCH ON ORIGINAL DRAWING.

JANUARY 201 DWG PA-03 SHEET

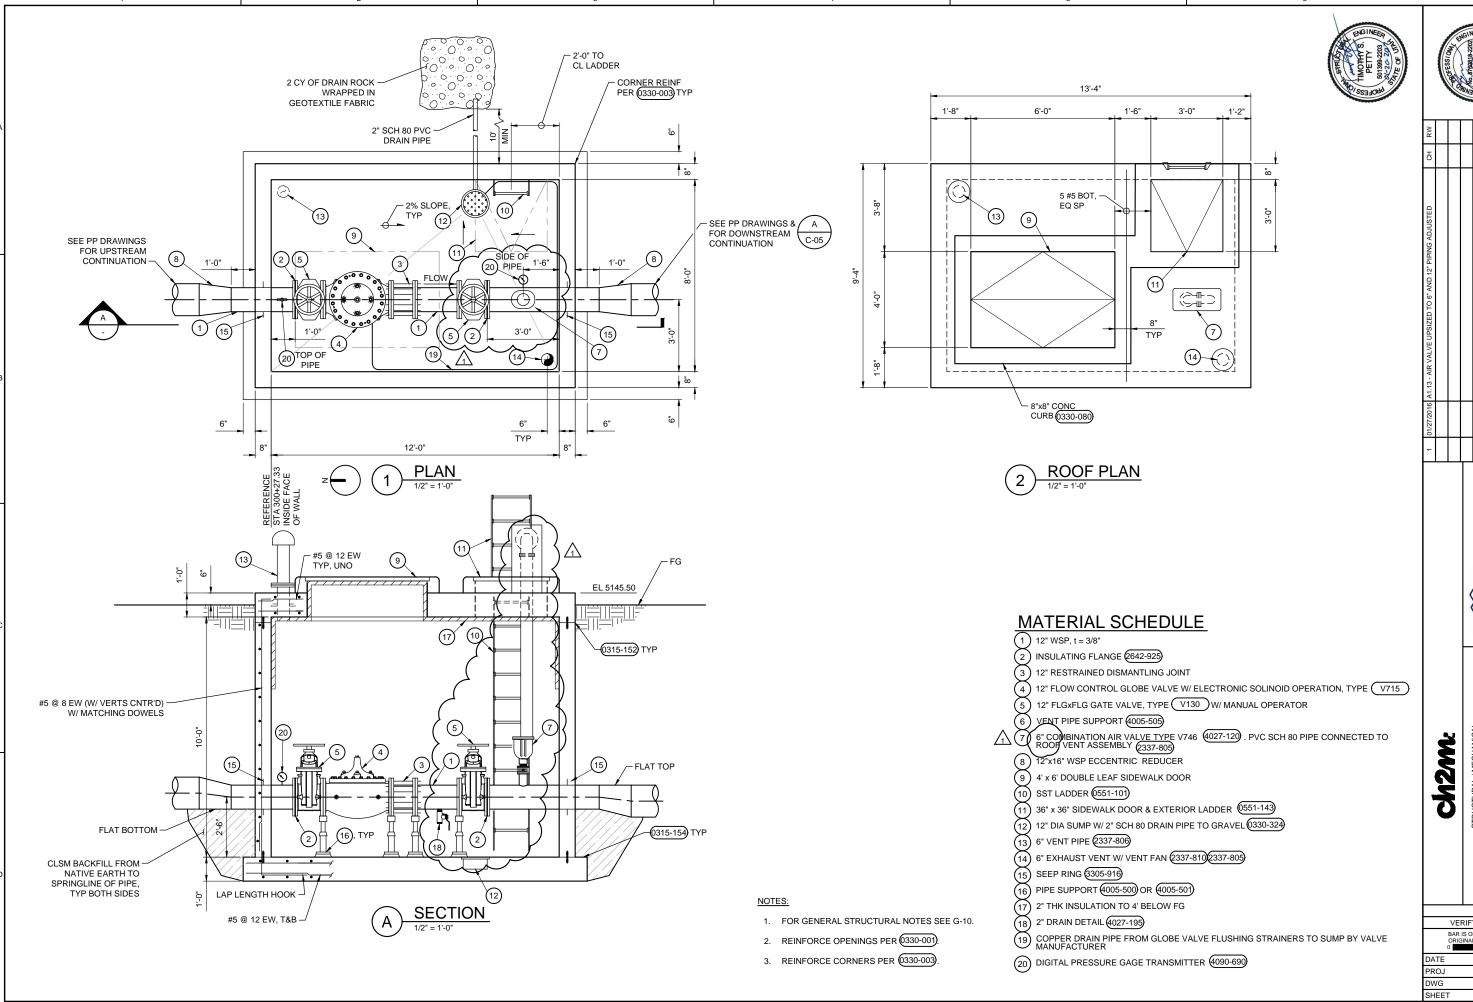



JORDAN VALLEY WATER
CONSERVANCY DISTRICT


PRV VAULT PLAN AND SECTIONS


VERIFY SCALE BAR IS ONE INCH ON ORIGINAL DRAWING.

JANUARY 201 SM-03

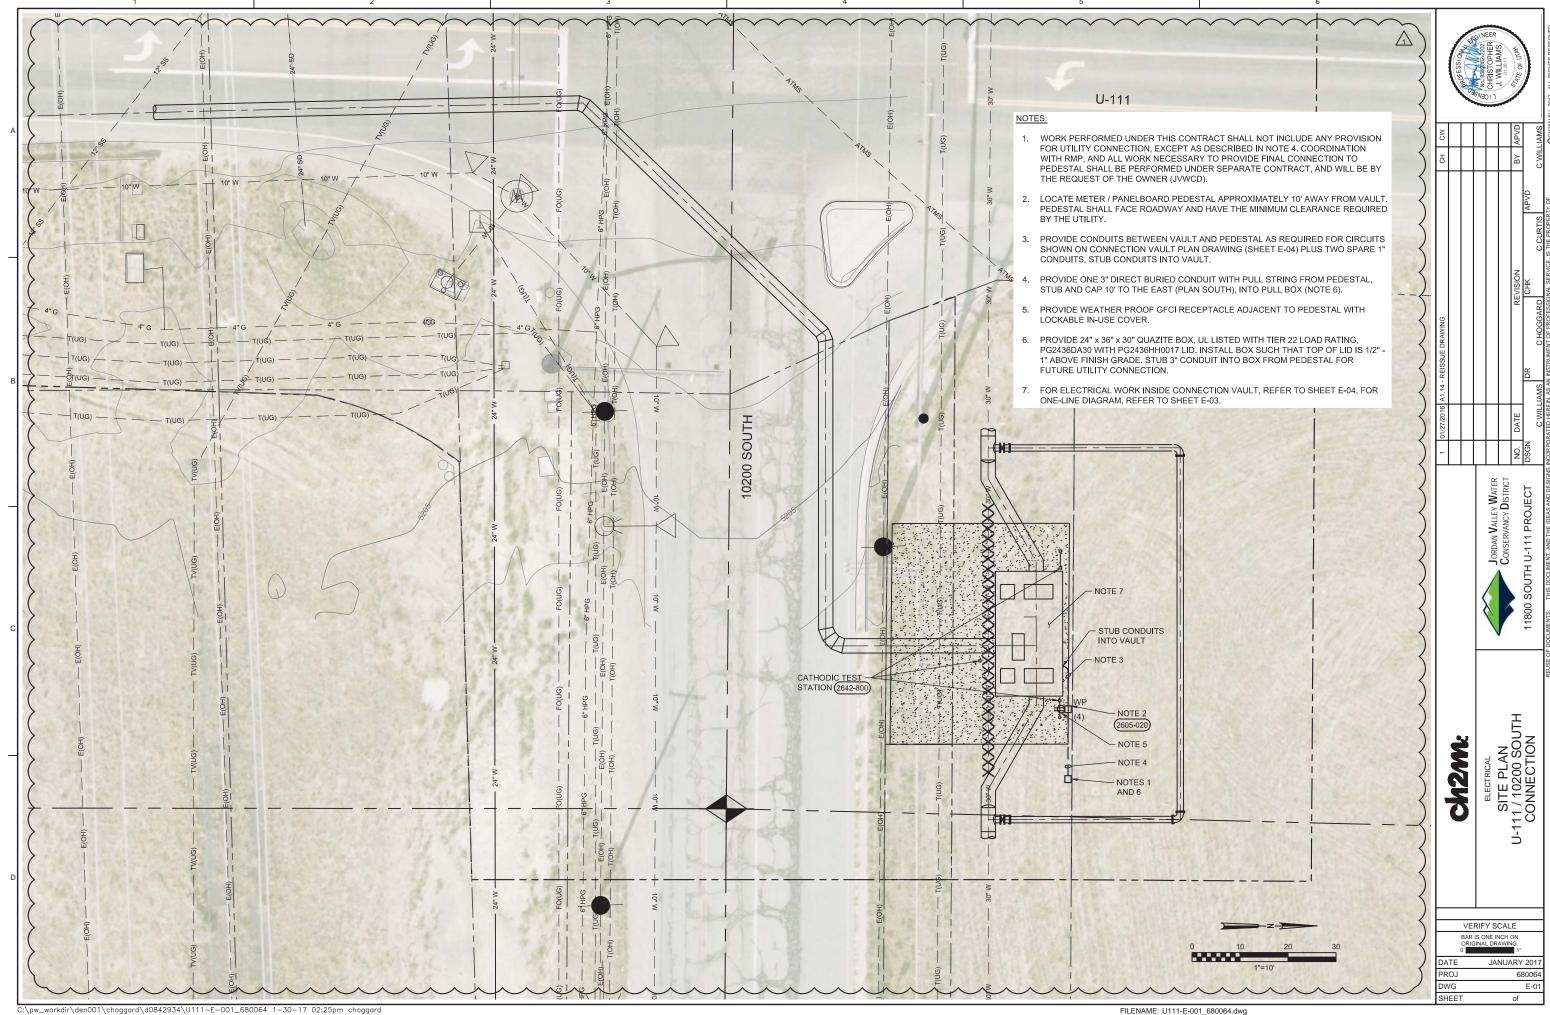

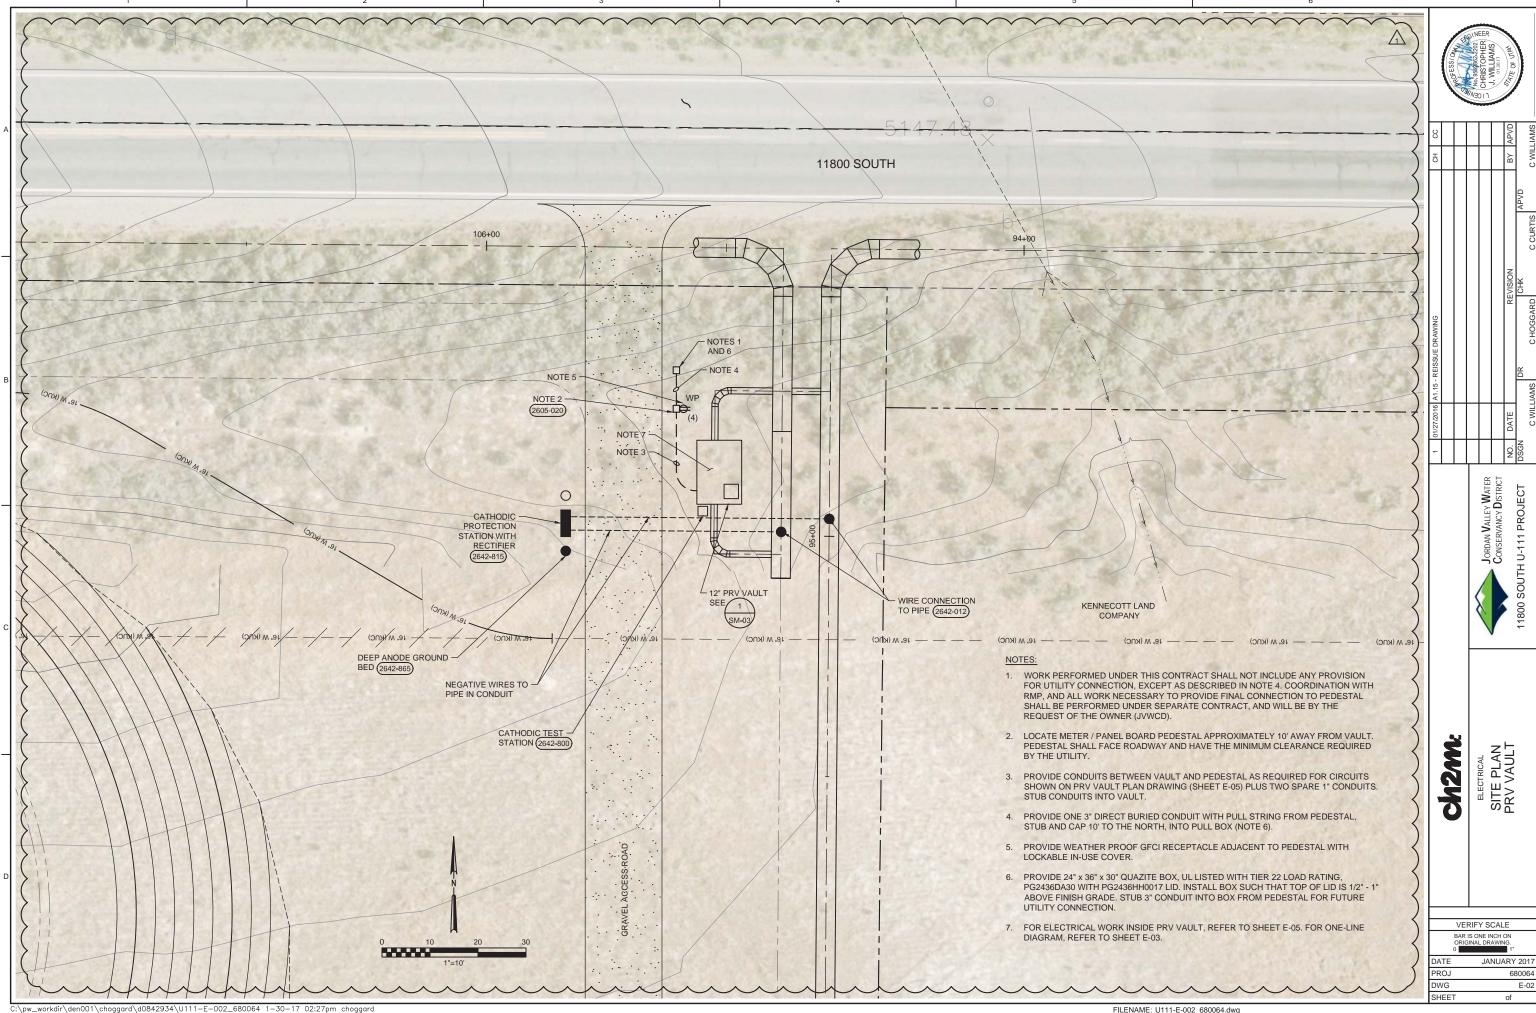

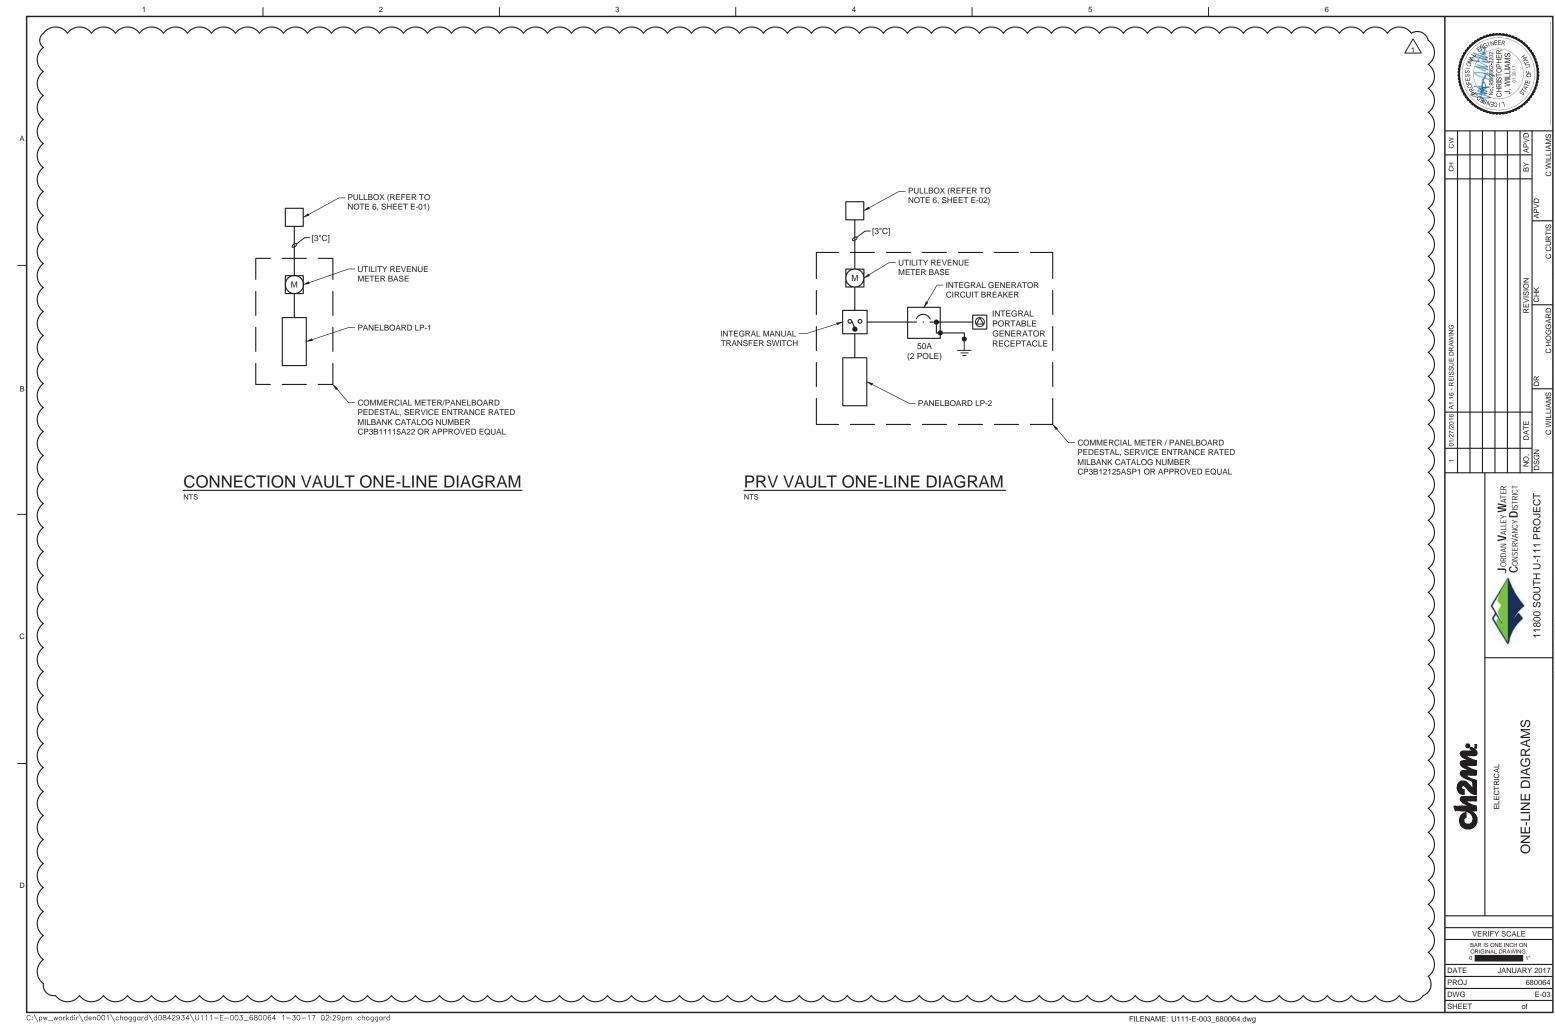

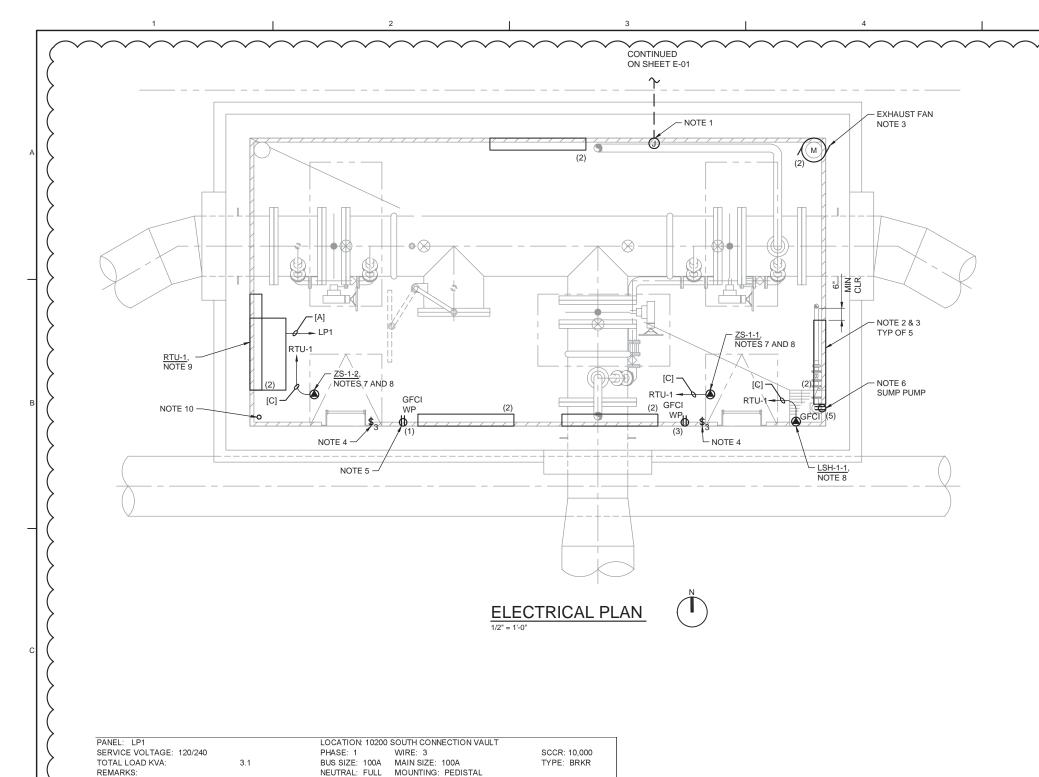

LOAD IN VA

180

1150

1000

2150

GENERAL NOTES:

A. NUMBERS IN PARENTHESIS (X) ADJACENT TO LIGHTS AND RECEPTACLES DENOTE CIRCUIT NUMBERS IN PANEL LP-1. PROVIDE #12 CONDUCTORS.

KEY NOTES:

- PROVIDE JUNCTION BOX(ES) ON VAULT WALL AT 24" BELOW TOP FOR CONDUIT TERMINATIONS. QUANTITY AS REQUIRED.
- 2. PROVIDE ENCLOSED AND GASKETED LINEAR LED LUMINAIRE, LITHONIA FEM-L48-600LMN-IMAFL-WD-MVOLT-40K OR APPROVED EQUAL. WALL MOUNT AT 7'-6" ABOVE FINISH FLOOR.
- 3. LIGHTS AND EXHAUST FAN SHALL BE WIRED IN PARALLEL AND CONTROLLED BY THE LIGHT SWITCHES ADJACENT TO THE ACCESS HATCHES.
- 4. MOUNT LIGHT SWITCH AT ELEVATION 5203.50 (6" BELOW VAULT HATCH) AND ADJACENT TO LADDER.
- 5. MOUNT CONVENIENCE RECEPTACLE 48" INCHES ABOVE FINISH FLOOR. CIRCUIT RECEPTACLE AS SHOWN. PROVIDE WET LOCATION IN-USE COVER.
- 6. PROVIDE 20A SIMPLEX RECEPTACLE FOR SUMP PUMP. MOUNT AT 48" ABOVE
- 7. ACCESS HATCH INTRUSION SWITCH, WIDE-GAP MAGNETIC CONTACT SWITCH, 120VAC RATING. MOUNT SWITCH INSIDE HATCH.
- 8. INSTALL CONDUITS EMBEDDED IN CONCRETE FROM HATCH INTRUSION SWITCH AND LEVEL SENSOR TO RTU-1.
- PROVIDE 36" x 48" x 18" ENCLOSED AND GASKETED ENCLOSURE WITH BACKPLANE. TURN BACKPLANE OVER TO OWNER, AS SCADA COMPONENTS WILL BE PROVIDED AND INSTALLED BY OWNER. REFER TO SPECIFICATION SECTION 26 05 01.2.17.
- 10. PROVIDE 2" MAST ARM WITH ANTENNA (2605-025)

CONDUCTOR TYPES:

[A] = 3/4"C, 2 #12, 1 #12G

[B] = 3/4"C, 1 #16TSP [C] = 3/4"C, 2 #14, 1 #14G

	SEESS OF	13 13 13 13 13 13 13 13 13 13 13 13 13 1	(A) No. 9542862-2202 Z	CHRISTOPHER 33	J. WILLIAMS	地方も世代)	
Š						APVD	C WILLIAMS	ŀ
5						ВУ	C WILI	
								l

-	01/27/2016	A1.17 -	1 01/27/2016 A1.17 - REISSUE DRAWING			СН	CW
Ñ.	DATE		REV	REVISION		ВУ	BY APVE
DSGN			DR	CHK	APVD		
	C WILLIAMS	LIAMS	CHOGGARD	C CURTIS	SI	C WILLIAMS	IAMS
NCORPC R IN PAR	RATED HERE T, FOR ANY O	IN, AS AN	NCORPORATED HEREIN, AS AN INSTRUMENT OF PROFESSIONAL SERVICE, IS THE PROPERTY OF R IN PART, FOR ANY OTHER PROJECT WITHOUT THE WRITTEN AUTHORIZATION OF CHEM HILL.	AL SERVICE, IS THE PRO AUTHORIZATION OF CH2	PERTY OF M HILL.		© CHZ

JORDAN VALLEY WATER
CONSERVANCY DISTRICT

ch2m.

VERIFY SCALE BAR IS ONE INCH ON ORIGINAL DRAWING.

JANUARY 201 E-04 SHEET

CIRCUIT DESCRIPTION

SW RECEPTACLE

SUMP PUMP RECEPTACLE

180 SE RECEPTACLE

SPARE

SPACE

SPACE SPACE

SPACE

A/P NO. NO. A/P

15 16

20/1 5 6 20/1 RTU-1

20/1 7 8 20/1 SPARE 9 10 SPACE

20/1 1 2 20/1 LIGHTS & EXHAUST FAN

20/1 3 4 20/1 OUTDOOR RECEPTACLE

SPACE

SPACE


SPACE

CIRCUIT DESCRIPTION

LOAD IN VA

180

360

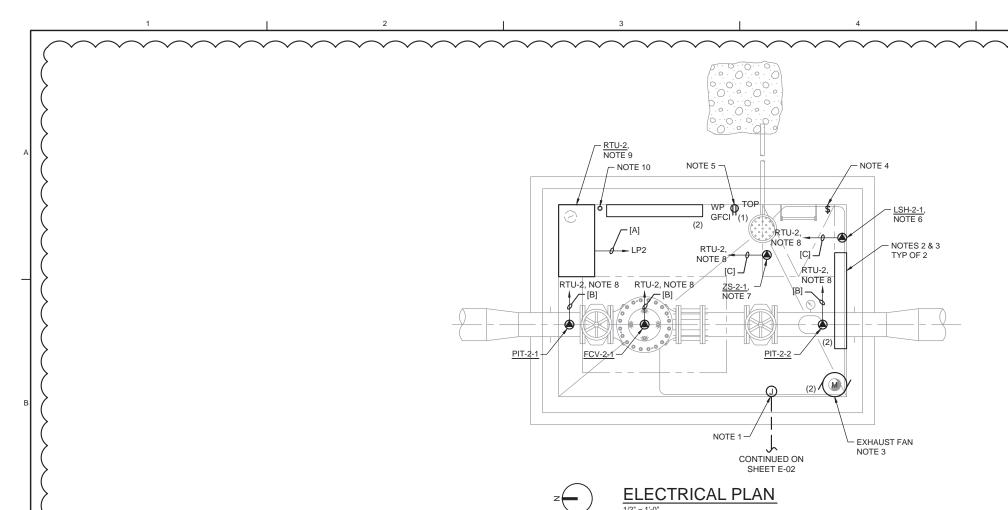

PANEL: LP2 LOCATION: 12" PRV VAULT SERVICE VOLTAGE: 120/240 PHASE: 1 WIRE: 3 SCCR: 10,000 BUS SIZE: 100A MAIN SIZE: 100A TOTAL LOAD KVA: 2.8 TYPE: BRKR NEUTRAL: FULL MOUNTING: PEDISTAL REMARKS: LOAD IN VA BKR CK CK BKR LOAD IN VA CIRCUIT DESCRIPTION A/P NO. NO. A/P CIRCUIT DESCRIPTION 180 AULT RECEPTACLE 20/1 1 2 20/1 LIGHTS & EXHAUST FAN 960 20/1 3 4 20/1 OUTDOOR RECEPTACLE 1000 RTU-2 180 500 CATHODIC PROTECTION RECTIFIER 20/1 5 6 20/1 SPARE SPARE 20/1 7 8 20/1 SPARE 9 10 SPACE SPACE SPACE SPACE 13 14 SPACE SPACE 680 1000 960

GENERAL NOTES:

A. NUMBERS IN PARENTHESIS (X) ADJACENT TO LIGHTS AND RECEPTACLES DENOTE CIRCUIT NUMBERS IN PANEL LP-2. PROVIDE #12 CONDUCTORS.

KEY NOTES:

- PROVIDE JUNCTION BOX(ES) ON VAULT WALL AT 24" BELOW TOP FOR CONDUIT TERMINATIONS. QUANTITY AS REQUIRED.
- PROVIDE ENCLOSED AND GASKETED LINEAR LED LUMINAIRE, LITHONIA FEM-L48-600LMN-IMAFL-WD-MVOLT-40K OR APPROVED EQUAL. WALL MOUNT AT 6" BELOW CEILING.
- LIGHTS AND EXHAUST FAN SHALL BE WIRED IN PARALLEL AND CONTROLLED BY THE LIGHT SWITCHES ADJACENT TO THE ACCESS HATCHES.
- 4. MOUNT LIGHT SWITCH 6" BELOW TOP OF VAULT AND ADJACENT TO LADDER.
- MOUNT CONVENIENCE RECEPTACLE 48" INCHES ABOVE FINISH FLOOR. CIRCUIT RECEPTACLE AS SHOWN. PROVIDE WET LOCATION IN-USE COVER.
- 6. MOUNT FLOOD ALARM SWITCH AT ELEVATION 4837.5. GEMS LS-3 OR EQUAL.
- ACCESS HATCH INTRUSION SWITCH, WIDE-GAP MAGNETIC CONTACT SWITCH, 120VAC RATING. MOUNT SWITCH INSIDE HATCH.
- 8. INSTALL CONDUIT, EMBEDDED IN CONCRETE, FROM HATCH INTRUSION SWITCH LEVEL SENSOR, PRESSURE INDICATING TRANSMITTERS, AND FLOW CONTROL VALVE TO CABINET. PROVIDE PULL STRING FOR FUTURE WIRING AND CONNECTION BY OTHERS.
- 9. PROVIDE 36"x48"x18" ENCLOSED AND GASKETED ENCLOSURE WITH BACKPLANE.
 TURN BACKPLANE OVER TO OWNER, AS SCADA COMPONENTS WILL BE PROVIDED
 AND INSTALLED BY OWNER. REFER TO SPECIFICATION SECTION 26 05 01.2.17.
- 10. PROVIDE 2" MAST ARM WITH ANTENNA (2605-025)

CONDUCTOR TYPES:

[A] = 3/4"C WITH PULL STRING

[B] = 3/4"C WITH PULL STRING

c] = 3/4 °C WITH PULL STRING C] = 3/4 °C WITH PULL STRING



)	L					_	HE
)	CW			APVD		C WILLIAMS	©CH2M HIL
)	Ю			ВУ		C WIL	
)					APVD		ΓΥ OF
)				REVISION	CHK	C CURTIS	AL SERVICE, IS THE PROPER
	/2016 A1.18 - REISSUE DRAWING			REV	DR IC	CHOGGARD	HEREIN, AS AN INSTRUMENT OF PROFESSIONAL SERVICE, IS THE PROPERTY OF ANY OTHER PROJECT WITHOUT THE WRITTEN A ITHORIZATION OF CHAM HILL
	A1.18 -					WILLIAMS	IN, AS AN
	/2016			TE.		WILL	HERE ANY O

JORDAN VALLEY WATER
CONSERVANCY DISTRICT
CONTITUTION TO DECT

RICAL PLAN

ch2m.

VERIFY SCALE

BAR IS ONE INCH ON
ORIGINAL DRAWING.
0

ATE

 DATE
 JANUARY 2017

 PROJ
 680064

 DWG
 E-05

 SHEET
 of

